

Work Order ID 98298

D3290-041

98298

Page 1

March-12-13 1:46:14 PM

Item ID: D3290-041

B98298

Accept

N900040100

Setup Start *NS1*

Revision ID:

Stop *NS2*

Item Name: Replacement Window Assembly

Start Date: 3/11/13 Start Qty: 4.00

4

Cust Item ID:

Required Date: 3/22/13 Req'd Qty: 4.00

4

Customer:

Reference:

Approvals: Process Plan: MCS Date: 13-03-15 Tooling: _____

Date: _____

QC: _____ Date: _____ SPC (Y/N): _____

Date: _____

Run Start *NR1*

Stop *NR2*

| Sequence ID/ Work Center ID | Operation Description | Set Up/ Run Hours | Tool ID | Tool # | Plan Code | Accept Qty | Reject Qty | Reject Number | Insp. Stamp |
|--------------------------------|--------------------------|----------------------|---------|--------|--------------|---------------|---------------|------------------|----------------|
|--------------------------------|--------------------------|----------------------|---------|--------|--------------|---------------|---------------|------------------|----------------|

| Draw Nbr | Revision Nbr |
|----------|--------------|
| D3290 | Rev C |

| | | |
|-----|----------|------|
| 150 | Pick Kit | 0.00 |
|-----|----------|------|

150

Packaging

Memo

0.00

Packaging

(9) SMO 13-07-29

| | | |
|-----|-----------|------|
| 160 | Small Fab | 0.00 |
|-----|-----------|------|

160

Small Fab

Memo

0.00

Small Fab

Assemble as per Dwg D3290
Clean D3290-041 and place in plastic wrap

(9) SMO 13-07-29

| | | |
|-----|---|------|
| 170 | QC5- Inspect part completeness to step on W/O | 0.00 |
|-----|---|------|

170

QC

Memo

0.00

Quality Control

(9) B07-25

80

NCR: Yes / No

WORK ORDER NON-CONFORMANCE / UPDATE

DQA: _____ Date: _____

QA Closed: _____ Date: _____

| | | | | | | | | | | | | | | | | | | |
|--|---|---|--------------------------------------|------------------------------------|------------------------------------|--------------------------------------|------------------------------------|------------------------------------|--|----------------------------------|--|------------------------------------|--|--------------------------------|------------------------------------|------------------------------------|-----------------------------------|--|
| Work Order: _____ Part No. _____ NCR No. _____ | DISPOSITION Rework <input type="checkbox"/> Scrap <input type="checkbox"/> Use-as-is <input type="checkbox"/> Work Order Update <input type="checkbox"/> | AGAINST DEPARTMENT/PROCESS <table style="width: 100%;"> <tr> <td>Skid-tube <input type="checkbox"/></td> <td>Crosstube <input type="checkbox"/></td> <td>Water Jet <input type="checkbox"/></td> <td>Engineering <input type="checkbox"/></td> </tr> <tr> <td>Machining <input type="checkbox"/></td> <td>Small Fab <input type="checkbox"/></td> <td>Prod. Eng. Coord. <input type="checkbox"/></td> <td>Quality <input type="checkbox"/></td> </tr> <tr> <td>Thermoforming <input type="checkbox"/></td> <td>Finishing <input type="checkbox"/></td> <td>Rec/Store/Packaging <input type="checkbox"/></td> <td>Other <input type="checkbox"/></td> </tr> <tr> <td>Large Fab <input type="checkbox"/></td> <td>Composite <input type="checkbox"/></td> <td>Supplier <input type="checkbox"/></td> <td></td> </tr> </table> | Skid-tube <input type="checkbox"/> | Crosstube <input type="checkbox"/> | Water Jet <input type="checkbox"/> | Engineering <input type="checkbox"/> | Machining <input type="checkbox"/> | Small Fab <input type="checkbox"/> | Prod. Eng. Coord. <input type="checkbox"/> | Quality <input type="checkbox"/> | Thermoforming <input type="checkbox"/> | Finishing <input type="checkbox"/> | Rec/Store/Packaging <input type="checkbox"/> | Other <input type="checkbox"/> | Large Fab <input type="checkbox"/> | Composite <input type="checkbox"/> | Supplier <input type="checkbox"/> | |
| Skid-tube <input type="checkbox"/> | Crosstube <input type="checkbox"/> | Water Jet <input type="checkbox"/> | Engineering <input type="checkbox"/> | | | | | | | | | | | | | | | |
| Machining <input type="checkbox"/> | Small Fab <input type="checkbox"/> | Prod. Eng. Coord. <input type="checkbox"/> | Quality <input type="checkbox"/> | | | | | | | | | | | | | | | |
| Thermoforming <input type="checkbox"/> | Finishing <input type="checkbox"/> | Rec/Store/Packaging <input type="checkbox"/> | Other <input type="checkbox"/> | | | | | | | | | | | | | | | |
| Large Fab <input type="checkbox"/> | Composite <input type="checkbox"/> | Supplier <input type="checkbox"/> | | | | | | | | | | | | | | | | |

| Root Cause | Date | Step | Qty | Description of work order update or Non-conformance | Initial Chief Eng | Action Description | Sign & Date | Verification | QC Inspector |
|---------------|------|------|-----|---|-------------------|--------------------|-------------|--------------|--------------|
| Doc/Data | | | | | | | | | |
| Equip/Tooling | | | | | | | | | |
| Operator | | | | | | | | | |
| Material | | | | | | | | | |
| Setup | | | | | | | | | |
| Other | | | | | | | | | |
| Process | | | | | | | | | |
| Supplier | | | | | | | | | |
| Training | | | | | | | | | |
| Unapproved | | | | | | | | | |

FAULT CATEGORY

| Landing Gear | General | Other |
|---|---|--|
| <input type="checkbox"/> Bending | <input type="checkbox"/> Bend | <input type="checkbox"/> Grain |
| <input type="checkbox"/> Centre Not Concentric to O/S | <input type="checkbox"/> BOM/Route | <input type="checkbox"/> Hardware |
| <input type="checkbox"/> Cracks | <input type="checkbox"/> Broken/Damaged | <input type="checkbox"/> Inspection Incomplete |
| <input type="checkbox"/> Crushed/Crimped | <input type="checkbox"/> Burrs | <input type="checkbox"/> Instructions Incomplete/Unclear |
| <input type="checkbox"/> Cuffs | <input type="checkbox"/> Contamination | <input type="checkbox"/> Maintenance |
| <input type="checkbox"/> Heat Treat | <input type="checkbox"/> Countersink | <input type="checkbox"/> Mislabeled |
| <input type="checkbox"/> Inspection Strip in Tube | <input type="checkbox"/> Cut Too Short | <input type="checkbox"/> Misread |
| <input type="checkbox"/> Ripples in Bend | <input type="checkbox"/> Drill Holes | <input type="checkbox"/> Offset |
| <input type="checkbox"/> Torque Waves in Extrusion | <input type="checkbox"/> Drawing | <input type="checkbox"/> Out of Calibration |
| <input type="checkbox"/> Turning Sequence | <input type="checkbox"/> Finish | <input type="checkbox"/> Out of Sequence |
| <input type="checkbox"/> Wave/Twist in Tube | <input type="checkbox"/> Folio | <input type="checkbox"/> Outside Dimensions |
| | | <input type="checkbox"/> Ovalized |
| | | <input type="checkbox"/> Over/Under tolerance |
| | | <input type="checkbox"/> Part Incorrect |
| | | <input type="checkbox"/> Part Lost/Missing |
| | | <input type="checkbox"/> Part Moved |
| | | <input type="checkbox"/> Positioned Wrong |
| | | <input type="checkbox"/> Power Loss/Surge |
| | | <input type="checkbox"/> Pressure/Forced |
| | | <input type="checkbox"/> Temperature/Cure |
| | | <input type="checkbox"/> Weld |
| | | <input type="checkbox"/> Wrong Stock Pulled |
| | | <input type="checkbox"/> Other |

Work Order ID 98298

98298

Page 2

March-12-13 1:46:14 PM

Item ID: D3290-041 Accept *N900040100* Setup Start *NS1*
 Revision ID: Stop *NS2*
 Item Name: Replacement Window Assembly
 Start Date: 3/11/13 Start Qty: 4.00 *4* Cust Item ID:
 Required Date: 3/22/13 Req'd Qty: 4.00 *4* Customer:
 Reference:

Approvals: Process Plan: _____ Date: _____ Tooling: _____ Date: _____ Run Start *NR1*
 QC: _____ Date: _____ SPC (Y/N): _____ Date: _____ Stop *NR2*

| Sequence ID/ Work Center ID | Operation Description | Set Up/ Run Hours | Tool ID | Tool # | Plan Code | Accept Qty | Reject Qty | Reject Number | Insp. Stamp |
|--------------------------------|--|----------------------|---------|--------|--------------|---------------|---------------|------------------|----------------|
| 180 | Identify as per dwg & Stock Location: <i>212</i> | 0.00 | | | | | | | |
| *180* | | | | | | | | | |
| Packaging | Memo | 0.00 | | | | | | | |
| Packaging | | | | | | | | | |
| 190 | QC21- Final Inspection - Work Order Release | 0.00 | | | | | | | |
| *190* | | | | | | | | | |
| QC | Memo | 0.00 | | | | | | | |
| Quality Control | | | | | | | | | |

13/7/31 *[Signature]*

13-07-30

NCR: Yes / No

WORK ORDER NON-CONFORMANCE / UPDATE

DQA: _____ Date: _____

QA Closed: _____ Date: _____

| | | | | | | | | | | | | | | | | | | |
|--|---|---|--------------------------------------|------------------------------------|------------------------------------|--------------------------------------|------------------------------------|------------------------------------|--|----------------------------------|--|------------------------------------|--|--------------------------------|------------------------------------|------------------------------------|-----------------------------------|--|
| Work Order: _____ Part No. _____ NCR No. _____ | DISPOSITION Rework <input type="checkbox"/> Scrap <input type="checkbox"/> Use-as-is <input type="checkbox"/> Work Order Update <input type="checkbox"/> | AGAINST DEPARTMENT/PROCESS <table style="width: 100%;"> <tr> <td>Skid-tube <input type="checkbox"/></td> <td>Crosstube <input type="checkbox"/></td> <td>Water Jet <input type="checkbox"/></td> <td>Engineering <input type="checkbox"/></td> </tr> <tr> <td>Machining <input type="checkbox"/></td> <td>Small Fab <input type="checkbox"/></td> <td>Prod. Eng. Coord. <input type="checkbox"/></td> <td>Quality <input type="checkbox"/></td> </tr> <tr> <td>Thermoforming <input type="checkbox"/></td> <td>Finishing <input type="checkbox"/></td> <td>Rec/Store/Packaging <input type="checkbox"/></td> <td>Other <input type="checkbox"/></td> </tr> <tr> <td>Large Fab <input type="checkbox"/></td> <td>Composite <input type="checkbox"/></td> <td>Supplier <input type="checkbox"/></td> <td></td> </tr> </table> | Skid-tube <input type="checkbox"/> | Crosstube <input type="checkbox"/> | Water Jet <input type="checkbox"/> | Engineering <input type="checkbox"/> | Machining <input type="checkbox"/> | Small Fab <input type="checkbox"/> | Prod. Eng. Coord. <input type="checkbox"/> | Quality <input type="checkbox"/> | Thermoforming <input type="checkbox"/> | Finishing <input type="checkbox"/> | Rec/Store/Packaging <input type="checkbox"/> | Other <input type="checkbox"/> | Large Fab <input type="checkbox"/> | Composite <input type="checkbox"/> | Supplier <input type="checkbox"/> | |
| Skid-tube <input type="checkbox"/> | Crosstube <input type="checkbox"/> | Water Jet <input type="checkbox"/> | Engineering <input type="checkbox"/> | | | | | | | | | | | | | | | |
| Machining <input type="checkbox"/> | Small Fab <input type="checkbox"/> | Prod. Eng. Coord. <input type="checkbox"/> | Quality <input type="checkbox"/> | | | | | | | | | | | | | | | |
| Thermoforming <input type="checkbox"/> | Finishing <input type="checkbox"/> | Rec/Store/Packaging <input type="checkbox"/> | Other <input type="checkbox"/> | | | | | | | | | | | | | | | |
| Large Fab <input type="checkbox"/> | Composite <input type="checkbox"/> | Supplier <input type="checkbox"/> | | | | | | | | | | | | | | | | |

| Root Cause | Date | Step | Qty | Description of work order update or Non-conformance | Initial Chief Eng | Action Description | Sign & Date | Verification | QC Inspector |
|---------------|------|------|-----|---|-------------------|--------------------|-------------|--------------|--------------|
| Doc/Data | | | | | | | | | |
| Equip/Tooling | | | | | | | | | |
| Operator | | | | | | | | | |
| Material | | | | | | | | | |
| Setup | | | | | | | | | |
| Other | | | | | | | | | |
| Process | | | | | | | | | |
| Supplier | | | | | | | | | |
| Training | | | | | | | | | |
| Unapproved | | | | | | | | | |

FAULT CATEGORY

| Landing Gear | General | Other |
|---|---|--|
| <input type="checkbox"/> Bending | <input type="checkbox"/> Bend | <input type="checkbox"/> Grain |
| <input type="checkbox"/> Centre Not Concentric to O/S | <input type="checkbox"/> BOM/Route | <input type="checkbox"/> Hardware |
| <input type="checkbox"/> Cracks | <input type="checkbox"/> Broken/Damaged | <input type="checkbox"/> Inspection Incomplete |
| <input type="checkbox"/> Crushed/Crimped | <input type="checkbox"/> Burrs | <input type="checkbox"/> Instructions Incomplete/Unclear |
| <input type="checkbox"/> Cuffs | <input type="checkbox"/> Contamination | <input type="checkbox"/> Maintenance |
| <input type="checkbox"/> Heat Treat | <input type="checkbox"/> Countersink | <input type="checkbox"/> Mislabeled |
| <input type="checkbox"/> Inspection Strip in Tube | <input type="checkbox"/> Cut Too Short | <input type="checkbox"/> Misread |
| <input type="checkbox"/> Ripples in Bend | <input type="checkbox"/> Drill Holes | <input type="checkbox"/> Offset |
| <input type="checkbox"/> Torque Waves in Extrusion | <input type="checkbox"/> Drawing | <input type="checkbox"/> Out of Calibration |
| <input type="checkbox"/> Turning Sequence | <input type="checkbox"/> Finish | <input type="checkbox"/> Out of Sequence |
| <input type="checkbox"/> Wave/Twist in Tube | <input type="checkbox"/> Folio | <input type="checkbox"/> Outside Dimensions |
| | | <input type="checkbox"/> Ovalized |
| | | <input type="checkbox"/> Over/Under tolerance |
| | | <input type="checkbox"/> Part Incorrect |
| | | <input type="checkbox"/> Part Lost/Missing |
| | | <input type="checkbox"/> Part Moved |
| | | <input type="checkbox"/> Positioned Wrong |
| | | <input type="checkbox"/> Power Loss/Surge |
| | | <input type="checkbox"/> Pressure/Forced |
| | | <input type="checkbox"/> Temperature/Cure |
| | | <input type="checkbox"/> Weld |
| | | <input type="checkbox"/> Wrong Stock Pulled |
| | | <input type="checkbox"/> Other |

Picklist Print

March-12-13 1:46:14 PM

Page 1

Work Order ID: 98298

Parent Item: D3290-041

Parent Item Name: Replacement Window Assembly

Start Date: 3/11/13

Required Date: 3/22/13

Start Qty: 4.00

Required Qty: 4.00

Comments: IPP B05.05.25 Added Step 11KJ/JLM
 IPP C06.05.09 Ecn 798 EC
 IPP Rev:D Now on Waterjet 06-06-16 JLM
 IPP rev E rev C dwg 07.09.28 EC verified by: DD

| Component Item ID/ Item Name | Replacement Item ID | Mfg/ Purch | Bin Item | Primary Location | Last Location | Route Seq ID | Unit of Measure | Qty on Hand | Qty per Kit | Total Qty | Qty Issued | Date Issued | Status |
|---------------------------------|------------------------|---------------|-------------|---------------------|------------------|-----------------|--------------------|-----------------|-------------|--------------|---------------|----------------|--------|
| D3290-1 Window Frame | | Manufactured | No | | | 150 | Each | 7.0000 | 1 | 4 | | | |
| | | | | <u>Location</u> | | <u>Loc Qty</u> | | <u>Loc Code</u> | | | | | |
| | | | | ST213 | | 7 | | | | | | | |
| | | | | 73721 | | 2 | | | | | | | |
| | | | | 89917 | | 1 | | | | | | | |
| | | | | 94420 | | 4 | | | | | | | |
| | | | | | | | | 102785 | (9) | | | | |
| D2126 Seal | | Manufactured | No | | | 150 | f | 337.6308 | 6.5 | 58.6 | | | |
| | | | | <u>Location</u> | | <u>Loc Qty</u> | | <u>Loc Code</u> | | | | | |
| | | | | ST405 | | 337.63079 | | | | | | | |
| | | | | 57106 | | 4 | | | | | | | |
| | | | | 68336 | | 2.44679 | | | | | | | |
| | | | | 89058 | | 331.184 | | | | | | | |
| | | | | | | | | 102729 | (26) | 32.5 | | | |
| D3290-3 Window | | Manufactured | No | | | 150 | Each | 10.0000 | 1 | | | | |
| | | | | <u>Location</u> | | <u>Loc Qty</u> | | <u>Loc Code</u> | | | | | |
| | | | | ST214A | | 10 | | | | | | | |
| | | | | 93792 | | 1 | | | | | | | |
| | | | | 94675 | | 9 | | | | | | | |
| | | | | | | | | 102931 | (9) | | | | |

NCR: Yes / No

WORK ORDER NON-CONFORMANCE / UPDATE

DQA: _____ Date: _____



QA Closed: _____ Date: _____

| | | | | | | | | | | | | | | | | | | |
|--|---|---|--------------------------------------|------------------------------------|------------------------------------|--------------------------------------|------------------------------------|------------------------------------|--|----------------------------------|--|------------------------------------|--|--------------------------------|------------------------------------|------------------------------------|-----------------------------------|--|
| Work Order: _____ Part No. _____ NCR No. _____ | DISPOSITION Rework <input type="checkbox"/> Scrap <input type="checkbox"/> Use-as-is <input type="checkbox"/> Work Order Update <input type="checkbox"/> | AGAINST DEPARTMENT/PROCESS <table style="width: 100%;"> <tr> <td>Skid-tube <input type="checkbox"/></td> <td>Crosstube <input type="checkbox"/></td> <td>Water Jet <input type="checkbox"/></td> <td>Engineering <input type="checkbox"/></td> </tr> <tr> <td>Machining <input type="checkbox"/></td> <td>Small Fab <input type="checkbox"/></td> <td>Prod. Eng. Coord. <input type="checkbox"/></td> <td>Quality <input type="checkbox"/></td> </tr> <tr> <td>Thermoforming <input type="checkbox"/></td> <td>Finishing <input type="checkbox"/></td> <td>Rec/Store/Packaging <input type="checkbox"/></td> <td>Other <input type="checkbox"/></td> </tr> <tr> <td>Large Fab <input type="checkbox"/></td> <td>Composite <input type="checkbox"/></td> <td>Supplier <input type="checkbox"/></td> <td></td> </tr> </table> | Skid-tube <input type="checkbox"/> | Crosstube <input type="checkbox"/> | Water Jet <input type="checkbox"/> | Engineering <input type="checkbox"/> | Machining <input type="checkbox"/> | Small Fab <input type="checkbox"/> | Prod. Eng. Coord. <input type="checkbox"/> | Quality <input type="checkbox"/> | Thermoforming <input type="checkbox"/> | Finishing <input type="checkbox"/> | Rec/Store/Packaging <input type="checkbox"/> | Other <input type="checkbox"/> | Large Fab <input type="checkbox"/> | Composite <input type="checkbox"/> | Supplier <input type="checkbox"/> | |
| Skid-tube <input type="checkbox"/> | Crosstube <input type="checkbox"/> | Water Jet <input type="checkbox"/> | Engineering <input type="checkbox"/> | | | | | | | | | | | | | | | |
| Machining <input type="checkbox"/> | Small Fab <input type="checkbox"/> | Prod. Eng. Coord. <input type="checkbox"/> | Quality <input type="checkbox"/> | | | | | | | | | | | | | | | |
| Thermoforming <input type="checkbox"/> | Finishing <input type="checkbox"/> | Rec/Store/Packaging <input type="checkbox"/> | Other <input type="checkbox"/> | | | | | | | | | | | | | | | |
| Large Fab <input type="checkbox"/> | Composite <input type="checkbox"/> | Supplier <input type="checkbox"/> | | | | | | | | | | | | | | | | |

| Root Cause | Date | Step | Qty | Description of work order update or Non-conformance | Initial Chief Eng | Action Description | Sign & Date | Verification | QC Inspector |
|---------------|------|------|-----|---|-------------------|--------------------|-------------|--------------|--------------|
| Doc/Data | | | | | | | | | |
| Equip/Tooling | | | | | | | | | |
| Operator | | | | | | | | | |
| Material | | | | | | | | | |
| Setup | | | | | | | | | |
| Other | | | | | | | | | |
| Process | | | | | | | | | |
| Supplier | | | | | | | | | |
| Training | | | | | | | | | |
| Unapproved | | | | | | | | | |

FAULT CATEGORY

| Landing Gear | General | Other |
|---|---|--|
| <input type="checkbox"/> Bending | <input type="checkbox"/> Bend | <input type="checkbox"/> Grain |
| <input type="checkbox"/> Centre Not Concentric to O/S | <input type="checkbox"/> BOM/Route | <input type="checkbox"/> Hardware |
| <input type="checkbox"/> Cracks | <input type="checkbox"/> Broken/Damaged | <input type="checkbox"/> Inspection Incomplete |
| <input type="checkbox"/> Crushed/Crimped | <input type="checkbox"/> Burrs | <input type="checkbox"/> Instructions Incomplete/Unclear |
| <input type="checkbox"/> Cuffs | <input type="checkbox"/> Contamination | <input type="checkbox"/> Maintenance |
| <input type="checkbox"/> Heat Treat | <input type="checkbox"/> Countersink | <input type="checkbox"/> Mislabeled |
| <input type="checkbox"/> Inspection Strip in Tube | <input type="checkbox"/> Cut Too Short | <input type="checkbox"/> Misread |
| <input type="checkbox"/> Ripples in Bend | <input type="checkbox"/> Drill Holes | <input type="checkbox"/> Offset |
| <input type="checkbox"/> Torque Waves in Extrusion | <input type="checkbox"/> Drawing | <input type="checkbox"/> Out of Calibration |
| <input type="checkbox"/> Turning Sequence | <input type="checkbox"/> Finish | <input type="checkbox"/> Out of Sequence |
| <input type="checkbox"/> Wave/Twist in Tube | <input type="checkbox"/> Folio | <input type="checkbox"/> Outside Dimensions |
| | | <input type="checkbox"/> Ovalized |
| | | <input type="checkbox"/> Over/Under tolerance |
| | | <input type="checkbox"/> Part Incorrect |
| | | <input type="checkbox"/> Part Lost/Missing |
| | | <input type="checkbox"/> Part Moved |
| | | <input type="checkbox"/> Positioned Wrong |
| | | <input type="checkbox"/> Power Loss/Surge |
| | | <input type="checkbox"/> Pressure/Forced |
| | | <input type="checkbox"/> Temperature/Cure |
| | | <input type="checkbox"/> Weld |
| | | <input type="checkbox"/> Wrong Stock Pulled |
| | | <input type="checkbox"/> Other |

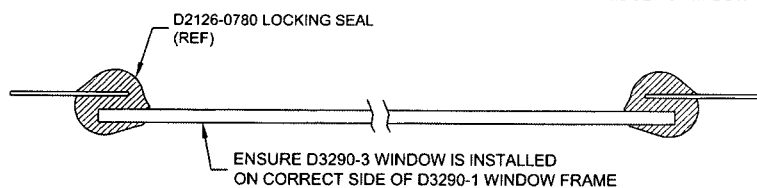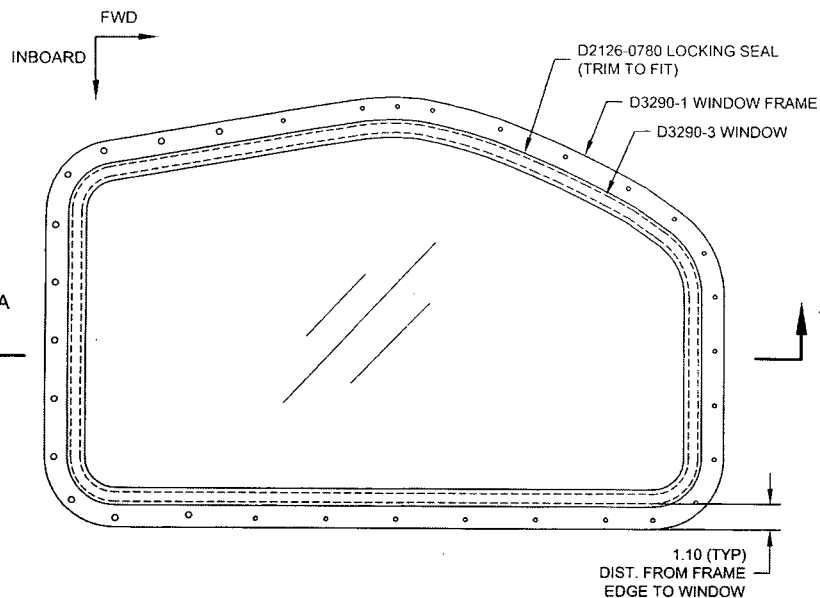


SECTION A-A
NTS

D3290-041 REPLACEMENT WINDOW ASSEMBLY

D3290-041 NOTES:
1) WEIGHT: 3.66 LBS

GENERAL NOTES:
1) TOLERANCES: PER DART QSI 018 UNLESS OTHERWISE NOTED
2) UNITS: INCHES UNLESS OTHERWISE NOTED

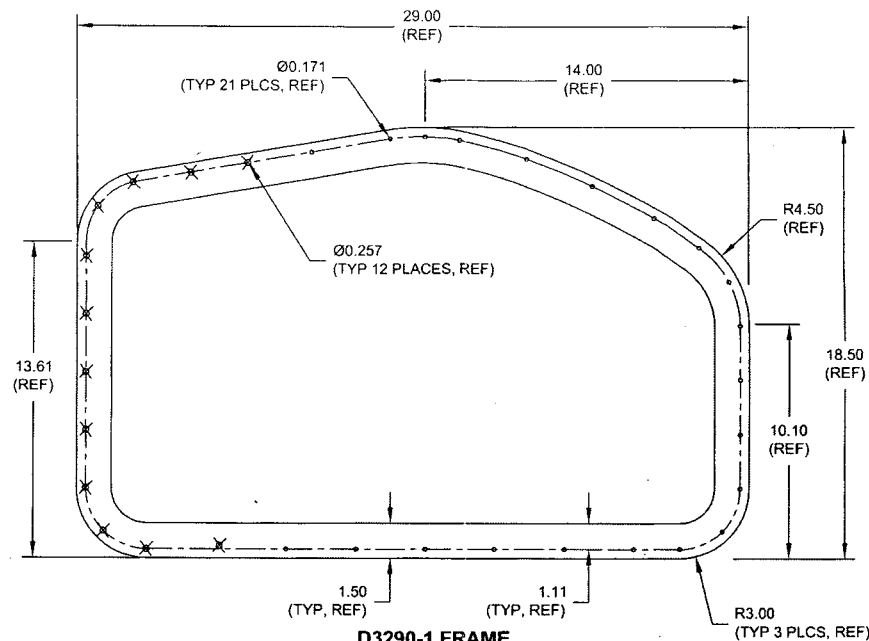

D3290-1 FRAME

D3290-1 NOTES:

- 1) MATERIAL: 6061-T6 (OR 6061-T62) ALUMINUM SHEET 0.040 THICK
PER AMS-QQ-A-250/11 OR AMS 4025 OR AMS 4027
(REF. DART SPEC. M6061T6S.040)
OR
5052-H32 ALUMINUM SHEET 0.040 THICK
PER AMS-QQ-A-250/8 OR AMS 4016
(REF. DART SPEC. M5052H32S.040)
- 2) FINISH: CHEMICAL CONVERSION COAT PER QSI 005 4.1
POWDER COAT WHITE (REF. 4.5.3.1) PER DART QSI 005 4.3
- 3) BREAK SHARP EDGES: 0.005 TO 0.010 MAX
- 4) IDENTIFICATION: IDENTIFY WITH DART P/N "D3290-1" USING FINE POINT PERMANENT INK MARKER
- 5) WEIGHT: 0.47 LBS

RELEASED
07.07.24
DEO ATTACHED

| C | UPDATE DIMS PER PAR 188 | DC | 07.07.24 |
|------------|-----------------------------|----|----------|
| B | UPDATE MATERIAL PER NCR 029 | MB | 06.04.20 |
| A | NEW ISSUE | RF | 04.06.14 |
| REV. | DESCRIPTION | BY | DATE |
| DESIGN | <i>[Signature]</i> | | |
| DRAWN | <i>[Signature]</i> | | |
| CHECKED | <i>[Signature]</i> | | |
| MFG. APPR. | <i>[Signature]</i> | | |
| APPROVED | <i>[Signature]</i> | | |
| DE APPR. | <i>[Signature]</i> | | |
| DATE | 07.07.24 | | |


| | |
|--|--------------|
| DART AEROSPACE LTD HAWKESBURY, ONTARIO, CANADA | |
| DRAWING NO. D3290 | REV. C |
| TITLE REPLACEMENT WINDOW ASSEMBLY | SHEET 1 OF 2 |
| SCALE 1:5 | |

COPYRIGHT © 2004 BY DART AEROSPACE LTD
THIS DOCUMENT IS PROPRIETARY AND CONFIDENTIAL AND IS SUPPLIED ON THE EXPRESS CONDITION THAT IT IS NOT TO BE USED FOR ANY PURPOSE OR COMMUNICATED TO ANY OTHER PERSON WITHOUT WRITTEN PERMISSION FROM DART AEROSPACE LTD.

UNDER REVIEW

98298 MLS
13-03-15
69/10/19

98298

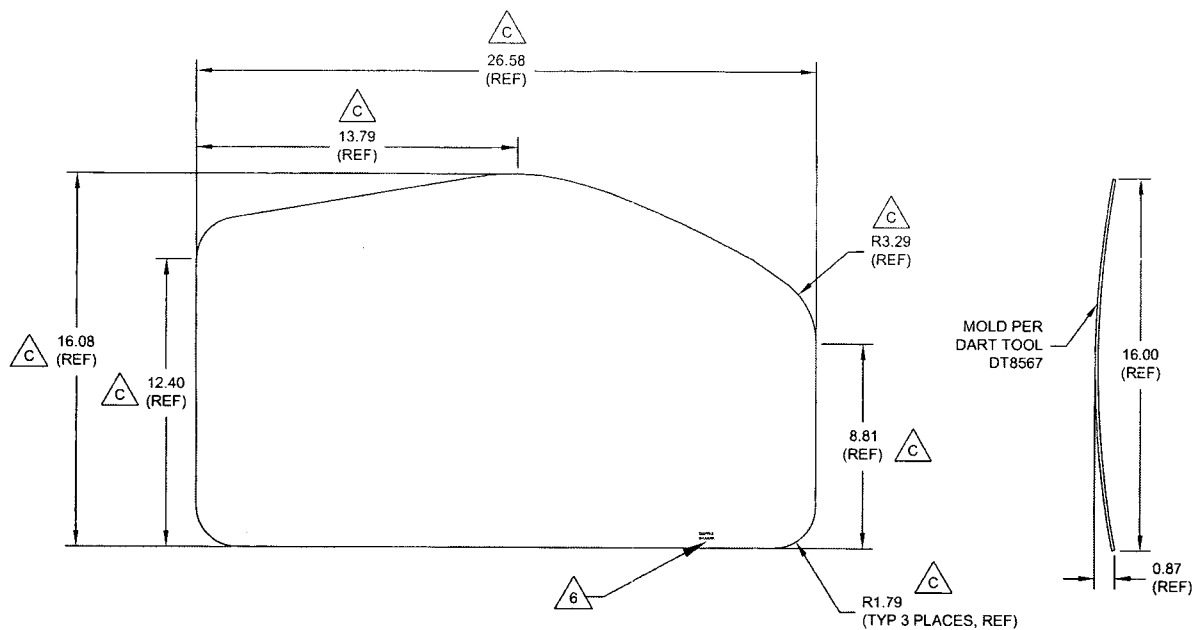

D3290-3 WINDOW

- D3290-3 NOTES:**
- 1) MATERIAL: POLYCAST II CLEAR ACRYLIC SHEET PER MIL-P-5425
OR PLEXIGLAS G CLEAR CAST ACRYLIC SHEET PER
LP-391 TYPE 1 GRADE C, 0.125 THICK
(REF. DART SPEC. M-ACRYLIC-S.125)
 - 2) FINISH: NONE
 - 3) TOLERANCES: PER DART QSI 018 UNLESS OTHERWISE NOTED
 - 4) UNITS: INCHES UNLESS OTHERWISE NOTED
 - 5) REMOVE SHARP EDGES
 - 6) IDENTIFICATION: ENGRAVE P/N "D3290-3" AND B/N ON LOWER EDGE
USE 0.125" HIGH LETTERS TO MAXIMUM DEPTH OF 0.005"
 - 7) WEIGHT: 1.87 +/- 0.42 LBS
 - 8) MOLD PER DART TOOL DT8567

WPA/10/19
UNDER REVIEW
06-08-18
DEO ATTACHED
RELEASED
07.09.22

| | | | |
|------------|-----------|---|--------------|
| DESIGN | <i>3E</i> | DART AEROSPACE LTD | |
| DRAWN | <i>JE</i> | HAWKESBURY, ONTARIO, CANADA | |
| CHECKED | <i>JE</i> | DRAWING NO. D3290 | REV. C |
| MFG. APPR. | <i>JE</i> | | SHEET 2 OF 2 |
| APPROVED | <i>JE</i> | TITLE | SCALE |
| DE APPR. | <i>JE</i> | REPLACEMENT WINDOW ASSEMBLY | 1:5 |
| DATE | 07.07.24 | COPYRIGHT © 2004 BY DART AEROSPACE LTD <small>THIS DOCUMENT IS PRIVATE AND CONFIDENTIAL AND IS SUPPLIED ON THE EXPRESS CONDITION THAT IT IS NOT TO BE USED FOR ANY PURPOSE OR COMMUNICATED TO ANY OTHER PERSON WITHOUT WRITTEN PERMISSION FROM DART AEROSPACE LTD.</small> | |

98298

| | | | | | | | |
|----------------------|--------------------------------------|------------------|---|--|-------------------------|---------------------------|--------------|
| DRAWING NO. D3290 | TITLE REPLACEMENT WINDOW ASSEMBLY | REV. C | DART AEROSPACE LTD ENGINEERING ORDER | | D.E.O. NO. D3290-C-1 | SHEET NO. SHEET 1 OF 1 | SCALE NTS |
| DRAWN 9P | CHECKED 1 | MFG. APPR. E | APPROVED W | | DE APPR. H | | |
| DATE 09.09.18 | DATE 09.09.18 | DATE 09.09.18 | DATE 09/09/21 | | DATE 09/09/21 | | |

PURPOSE:

CHANGE MATERIAL THICKNESS OF D3290-1 FRAME TO 0.063 FROM 0.040. REF PAR 09-033.

CHANGE:

MATERIAL CALL-OUT OF D3290-1 FRAME ON SHEET 1 IS AMENDED AS FOLLOWS:

D3290-1 NOTES

- 1) MATERIAL: 6061-T6 (OR 6061-T62) ALUMINUM SHEET ~~0.040 THICK~~ 0.063 THICK (REPLACE)
 PER AMS-QQ-A-250/11 OR AMS 4025 OR AMS 4027
~~(REF. DART SPEC. M6061T6S.040)~~ REF. DART SPEC. M6061T6S.063 (REPLACE)
 OR
 5052-H32 ALUMINUM SHEET ~~0.040 THICK~~ 0.063 THICK (REPLACE)
 PER AMS-QQ-A-250/8 OR AMS 4016
~~(REF. DART SPEC. M5052H32S.040)~~ REF. DART SPEC. M5052H32S.063 (REPLACE)

RELEASED
 2009-10-09
 W

COPYRIGHT © 2009 BY DART AEROSPACE LTD
 THIS DOCUMENT IS PRIVATE AND CONFIDENTIAL AND IS SUPPLIED ON THE EXPRESS CONDITION THAT IT IS
 NOT TO BE USED FOR ANY PURPOSE OR COPIED OR COMMUNICATED TO ANY OTHER PERSON WITHOUT
 WRITTEN PERMISSION FROM DART AEROSPACE LTD.